



Ministry
of the
Environment
Ontario

USE PERMIT
FOR CLASS 4, 5, 6 SEWAGE SYSTEMS

APPLICATION NO.

WA-56-86

INSPECTION DETAILS	TIME	DATE	WEATHER
	3:30pm	Dec 2/86	SNOW.
REPRESENTING:	THE OWNER	THE INSTALLER	

1. Work authorized by the Certificate of Approval has been satisfactorily completed and includes:

- a) ☒ Septic tank/holding tank of working capacity of 850 Imp. Gals. constructed of steel ☐ concrete ☒ fibreglass ☐ on site ☐ or prefabricated ☒ to serve 3 (no. of bedrooms or units).


MAKE AND MODEL,
IF PREFABRICATED TANK

Orillia Precast

- b) Leaching bed of total 72 lineal feet of 3 inch diameter distribution pipe of Daymond
clankm Pvc (type and product description e.g. Canron CSA Approved PVC) laid in 4 runs and fed by
pump (gravity, siphon, pump)
c) Proprietary Aerobic System: (Manufacturer) N/A (Model) N/A
d) Other details Filter. Area. 22m² or 12x20' = 240ft².

2. Location

- a) System components installed as shown on application supporting Certificate of Approval ☐
b) If located other than in (a) use space below for sketch and dimensions from permanent points of reference sufficient to facilitate future location of tank and leaching bed including orientation of pipe runs.

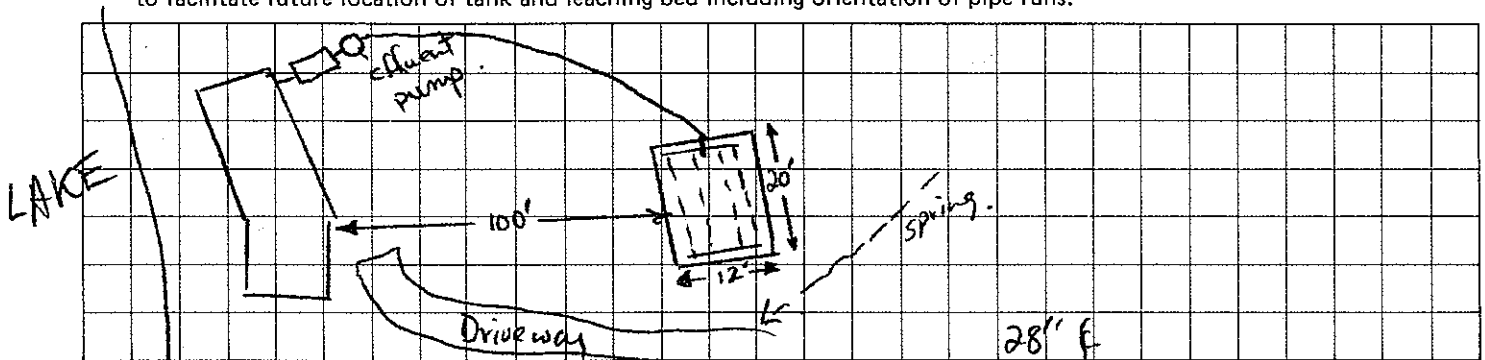

3. The following work remains to be completed:-

- ☒ Backfill System and Complete
☐ Stabilize All Sloped Surfaces

- ☐ Finish Grading to Shed Run-off and Divert Water Around Leaching Bed
☒ Other ensure spring (or runoff) is redirected around Filter Bed.

USE PERMIT

Under Section 59a of The Environmental Protection Act, 1971 and subject to the provisions of The Act and Regulations a Permit is hereby issued to (Owner) Paul Suter. for the use and operation of the Class 4F sewage system constructed/installed/enlarged/extended/alterd pursuant to the Certificate of Approval issued under the above application number in accordance with the application and Certificate of Approval with any changes indicated above and located on Lot 35 Concession 2 Ward/Township/Municipality WATT Region/District/County Muskoka Lakes Plan No. _____ Sub-Lot No. _____

INSPECTED AND RECOMMENDED BY

Sandy Poo

PERMIT ISSUED BY

[Signature]

DIRECTOR

DATE ISSUED

Dec 15/86

Note: Section 57(a) of The Act provides that no change can be made to any building(s) or structure(s) in connection with which this sewage system is used, if the operation or effectiveness of the sewage system will or is likely to be affected by the change, unless a new Certificate of Approval is obtained.

Section 78 of The Act provides that an applicant for a permit may appeal a decision to refuse to issue a permit. Written notice of appeal must be forwarded to the Director (who refused to issue the permit) and to the Environmental Appeal