Ministry of the Environment
Ontario

# USE PERMIT
## FOR CLASS 4, 5, 6 SEWAGE SYSTEMS

APPLICATION NO. Br/2/79

| | | | |
|---|---|---|---|
| INSPECTION DETAILS | TIME 3:00 pm | DATE June 22/79 | WEATHER Overcast |
| REPRESENTING: | THE OWNER | | THE INSTALLER Longyear Haulage |

**1. Work authorized by the Certificate of Approval has been satisfactorily completed and includes:**

a) Septic tank/holding tank of working capacity of 800 Imp. Gals. constructed of steel ☐ concrete ☒ fibreglass ☐ on site ☐ or prefabricated ☒ to serve 3 (no. of bedrooms or units).

MAKE AND MODEL, IF PREFABRICATED TANK: BROOKLIN

b) Leaching bed of total 200 lineal feet of 4 inch diameter distribution pipe of PVC (type and product description e.g. Canron CSA Approved PVC) laid in 4 runs and fed by (gravity, siphon, pump).

c) Proprietary Aerobic System: (Manufacturer) _____ (Model) _____

d) Other details HYDR-O-MATIC SP-33 PUMP

**2. Location**

a) System components installed as shown on application supporting Certificate of Approval ☐

b) If located other than in (a) use space below for sketch and dimensions from permanent points of reference sufficient to facilitate future location of tank and leaching bed including orientation of pipe runs.

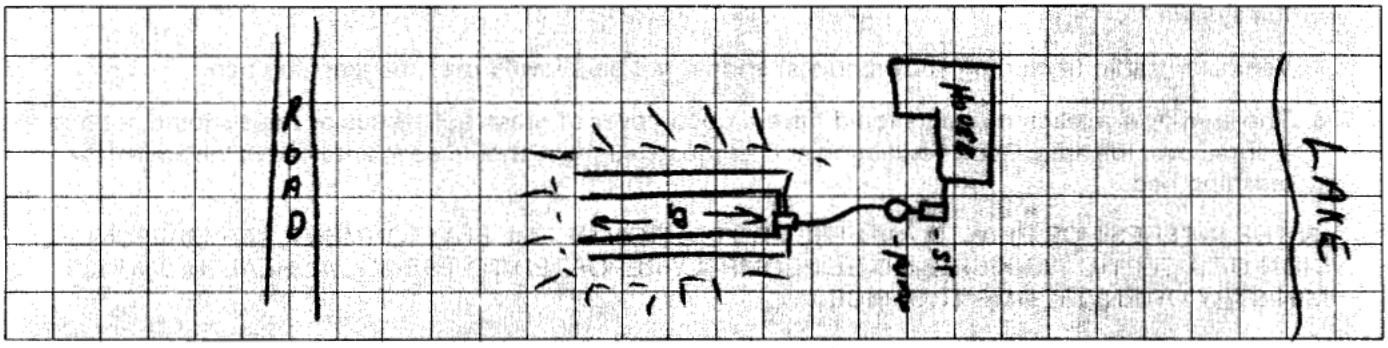


**3. The following work remains to be completed:–**

☒ Backfill System and Complete

☒ Stabilize All Sloped Surfaces

☐ Finish Grading to Shed Run-off and Divert Water Around Leaching Bed

☐ Other . . . . . .

## USE PERMIT

Under Section 59a of The Environmental Protection Act, 1971 and subject to the provisions of The Act and Regulations a Permit is hereby issued to (Owner) [redacted] for the use and operation of the Class IV sewage system constructed/installed/enlarged/extended/altered persuant to the Certificate of Approval issued under the above application number in accordance with the application and Certificate of Approval with any changes indicated above and located on Lot 1 Concession 10 Ward/Township/Municipality Brunel Region/District/County Muskoka Plan No. BR-1098 Sub-Lot No. -- 24

| INSPECTED AND RECOMMENDED BY | PERMIT ISSUED BY | DATE ISSUED |
|---|---|---|
| M. D. Dawson | David N. Kerr DIRECTOR | June 22, 1979 |

**Note:** Section 57(a) of The Act provides that no change can be made to any building(s) or structure(s) in connection with which this sewage system is used, if the operation or effectiveness of the sewage system will or is likely to be affected by the change, unless a new Certificate of Approval is obtained.

Section 78 of The Act provides that an applicant for a permit may appeal a decision to refuse to issue a permit. Written notice of appeal must be forwarded to the Director (who refused to issue the permit) and to the Environmental Appeal Board, 1 St. Clair Avenue West, Toronto, Ontario, M4V 1K7 within 15 days of receipt of a permit.

MOE 14-249/1042

OFFICE COPY